


Flächenaufstellung Obergeschoss:

Flur	43,81m <sup>2</sup>
Zimmer 4	14,04m <sup>2</sup>
Zimmer 5	12,94m <sup>2</sup>
Bad 5	3,23m <sup>2</sup>
Zimmer 6	12,64m <sup>2</sup>
Bad 6	1,80m <sup>2</sup>
Zimmer 7	12,83m <sup>2</sup>
Bad 7	2,71m <sup>2</sup>
Bad	4,14m <sup>2</sup>
WC	2,44m <sup>2</sup>
Gang	8,71m <sup>2</sup>
Abstellraum	2,88m <sup>2</sup>
Zimmer 8	20,02m <sup>2</sup>
WC 8	1,80m <sup>2</sup>
Zimmer 9	16,33m <sup>2</sup>
Bad 9	2,13m <sup>2</sup>
Privatwhg:	
Vorraum	2,88m <sup>2</sup>
Bad	3,86m <sup>2</sup>
Wohnzimmer	19,93m <sup>2</sup>
Kinderzimmer	17,68m <sup>2</sup>
Schlafzimmer	18,08m <sup>2</sup>
Gesamtfläche	224,86m <sup>2</sup>

- ⑧ Bad 5 RH=249 Fliesen 3,23 m<sup>2</sup>
- ⑨ Bad 6 RH=219 Kunststoff 1,80 m<sup>2</sup>
- ⑩ Bad 7 RH=240 Fliesen 2,71 m<sup>2</sup>
- ⑪ Bad 8 RH=233 Fliesen 4,14 m<sup>2</sup>
- ⑫ WC 8 RH=259 Fliesen 2,44 m<sup>2</sup>
- ⑬ WC 9 RH=246 Kunststoff 2,13 m<sup>2</sup>
- ⑭ Bad 9 RH=233 Kunststoff 2,13 m<sup>2</sup>
- ⑮ Abstellraum RH=234 Holzbohlen 2,88 m<sup>2</sup>
- ⑯ Vorraum RH=324 Parkett 2,86 m<sup>2</sup>
- ⑰ Bad RH=322 Parkett 3,86 m<sup>2</sup>

Grundriss Obergeschoss  
M 1:100

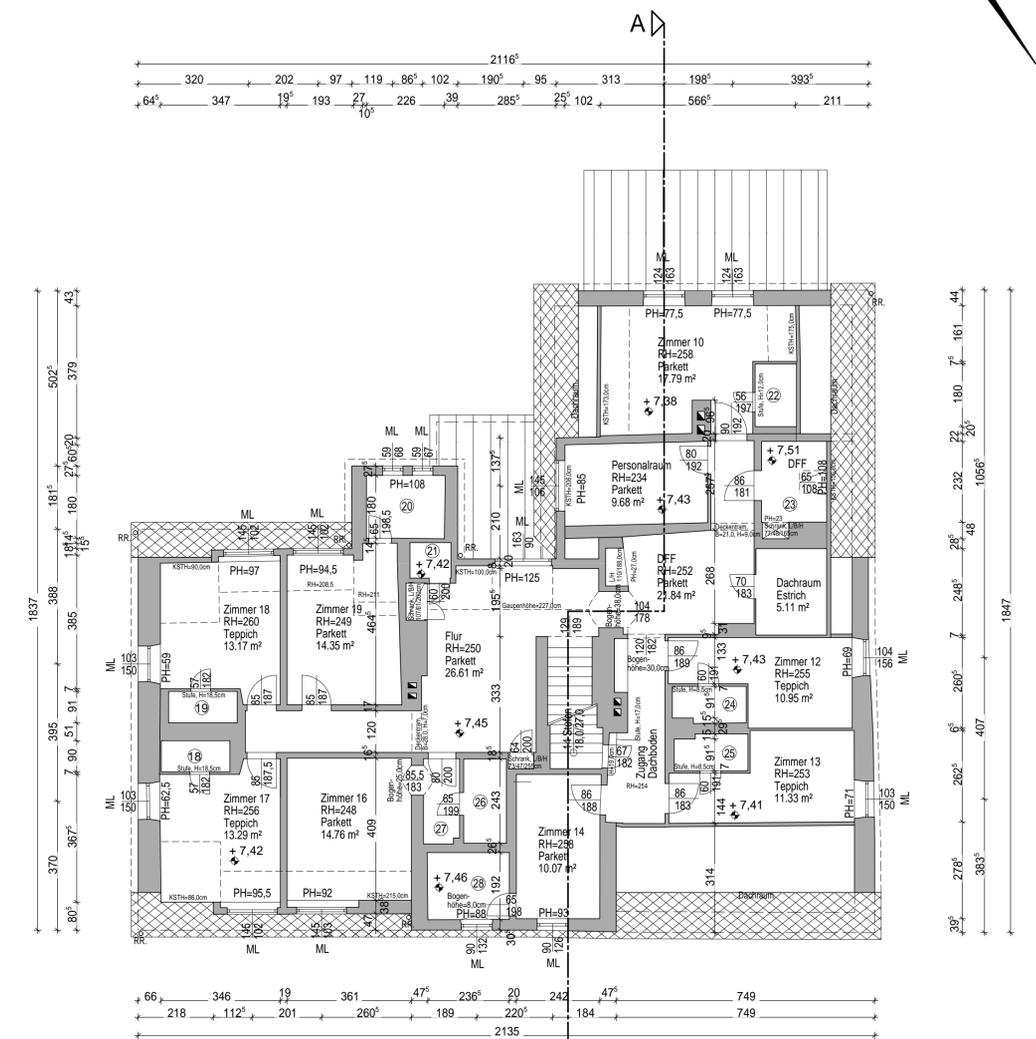


- ⑱ Bad 17 RH=218 Kunststoff 1,79 m<sup>2</sup>
- ⑲ Bad 18 RH=219 Kunststoff 1,81 m<sup>2</sup>
- ⑳ Bad 19 RH=213 Fliesen 4,11 m<sup>2</sup>
- ㉑ WC RH=214 Fliesen 1,21 m<sup>2</sup>
- ㉒ Bad 10 RH=220 Kunststoff 2,16 m<sup>2</sup>
- ㉓ Lagerraum RH=213 Parkett 4,38 m<sup>2</sup>
- ㉔ Bad 12 RH=230 Fliesen 2,18 m<sup>2</sup>
- ㉕ Bad 13 RH=230 Fliesen 2,19 m<sup>2</sup>
- ㉖ Bad 16 RH=259 Fliesen 3,01 m<sup>2</sup>
- ㉗ Vorraum 16 RH=261 Parkett 2,53 m<sup>2</sup>
- ㉘ Bad 14 RH=257 Fliesen 4,57 m<sup>2</sup>

Grundriss Dachgeschoss  
M 1:100

Flächenaufstellung Dachgeschoss:

Flur	26,61m <sup>2</sup>
Gang	21,84m <sup>2</sup>
Zimmer 10	17,79m <sup>2</sup>
Bad 10	2,16m <sup>2</sup>
Personalraum	9,68m <sup>2</sup>
Lagerraum	4,38m <sup>2</sup>
Dachraum	5,11m <sup>2</sup>
Zimmer 12	10,95m <sup>2</sup>
Bad 12	2,18m <sup>2</sup>
Zimmer 13	11,33m <sup>2</sup>
Bad 13	2,19m <sup>2</sup>
Zimmer 14	10,07m <sup>2</sup>
Bad 14	4,57m <sup>2</sup>
Zimmer 16	14,76m <sup>2</sup>
Vorraum Z. 16	2,53m <sup>2</sup>
Bad 16	3,01m <sup>2</sup>
Zimmer 17	13,29m <sup>2</sup>
Bad 17	1,73m <sup>2</sup>
Zimmer 18	13,17m <sup>2</sup>
Bad 18	1,81m <sup>2</sup>
Zimmer 19	14,35m <sup>2</sup>
Bad 19	4,11m <sup>2</sup>
WC	1,21m <sup>2</sup>
Gesamtfläche:	198,89m <sup>2</sup>

Grundriss Dachboden  
M 1:100

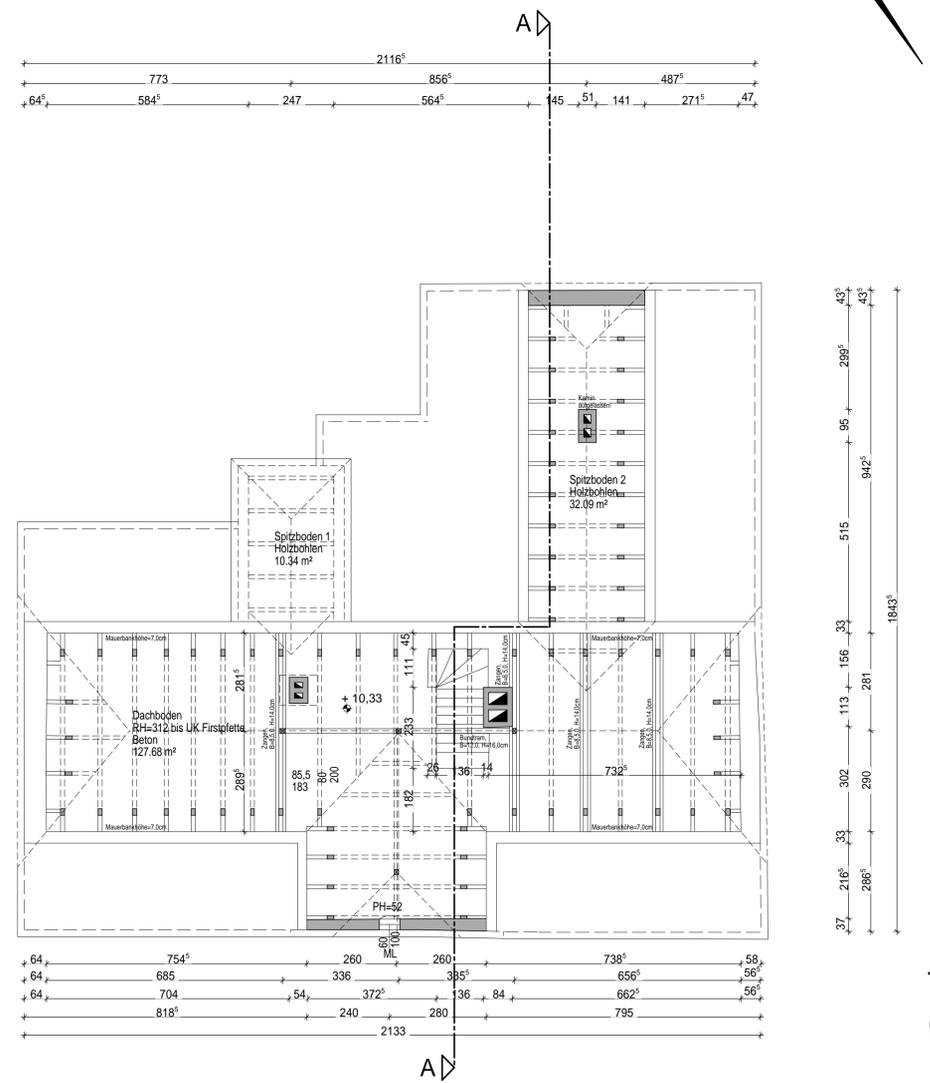

Bestandsplan Gasthof Forsthaus - Fam. Übeleis

Grundrisse

Stand: 25.04.2006  
M 1:100